



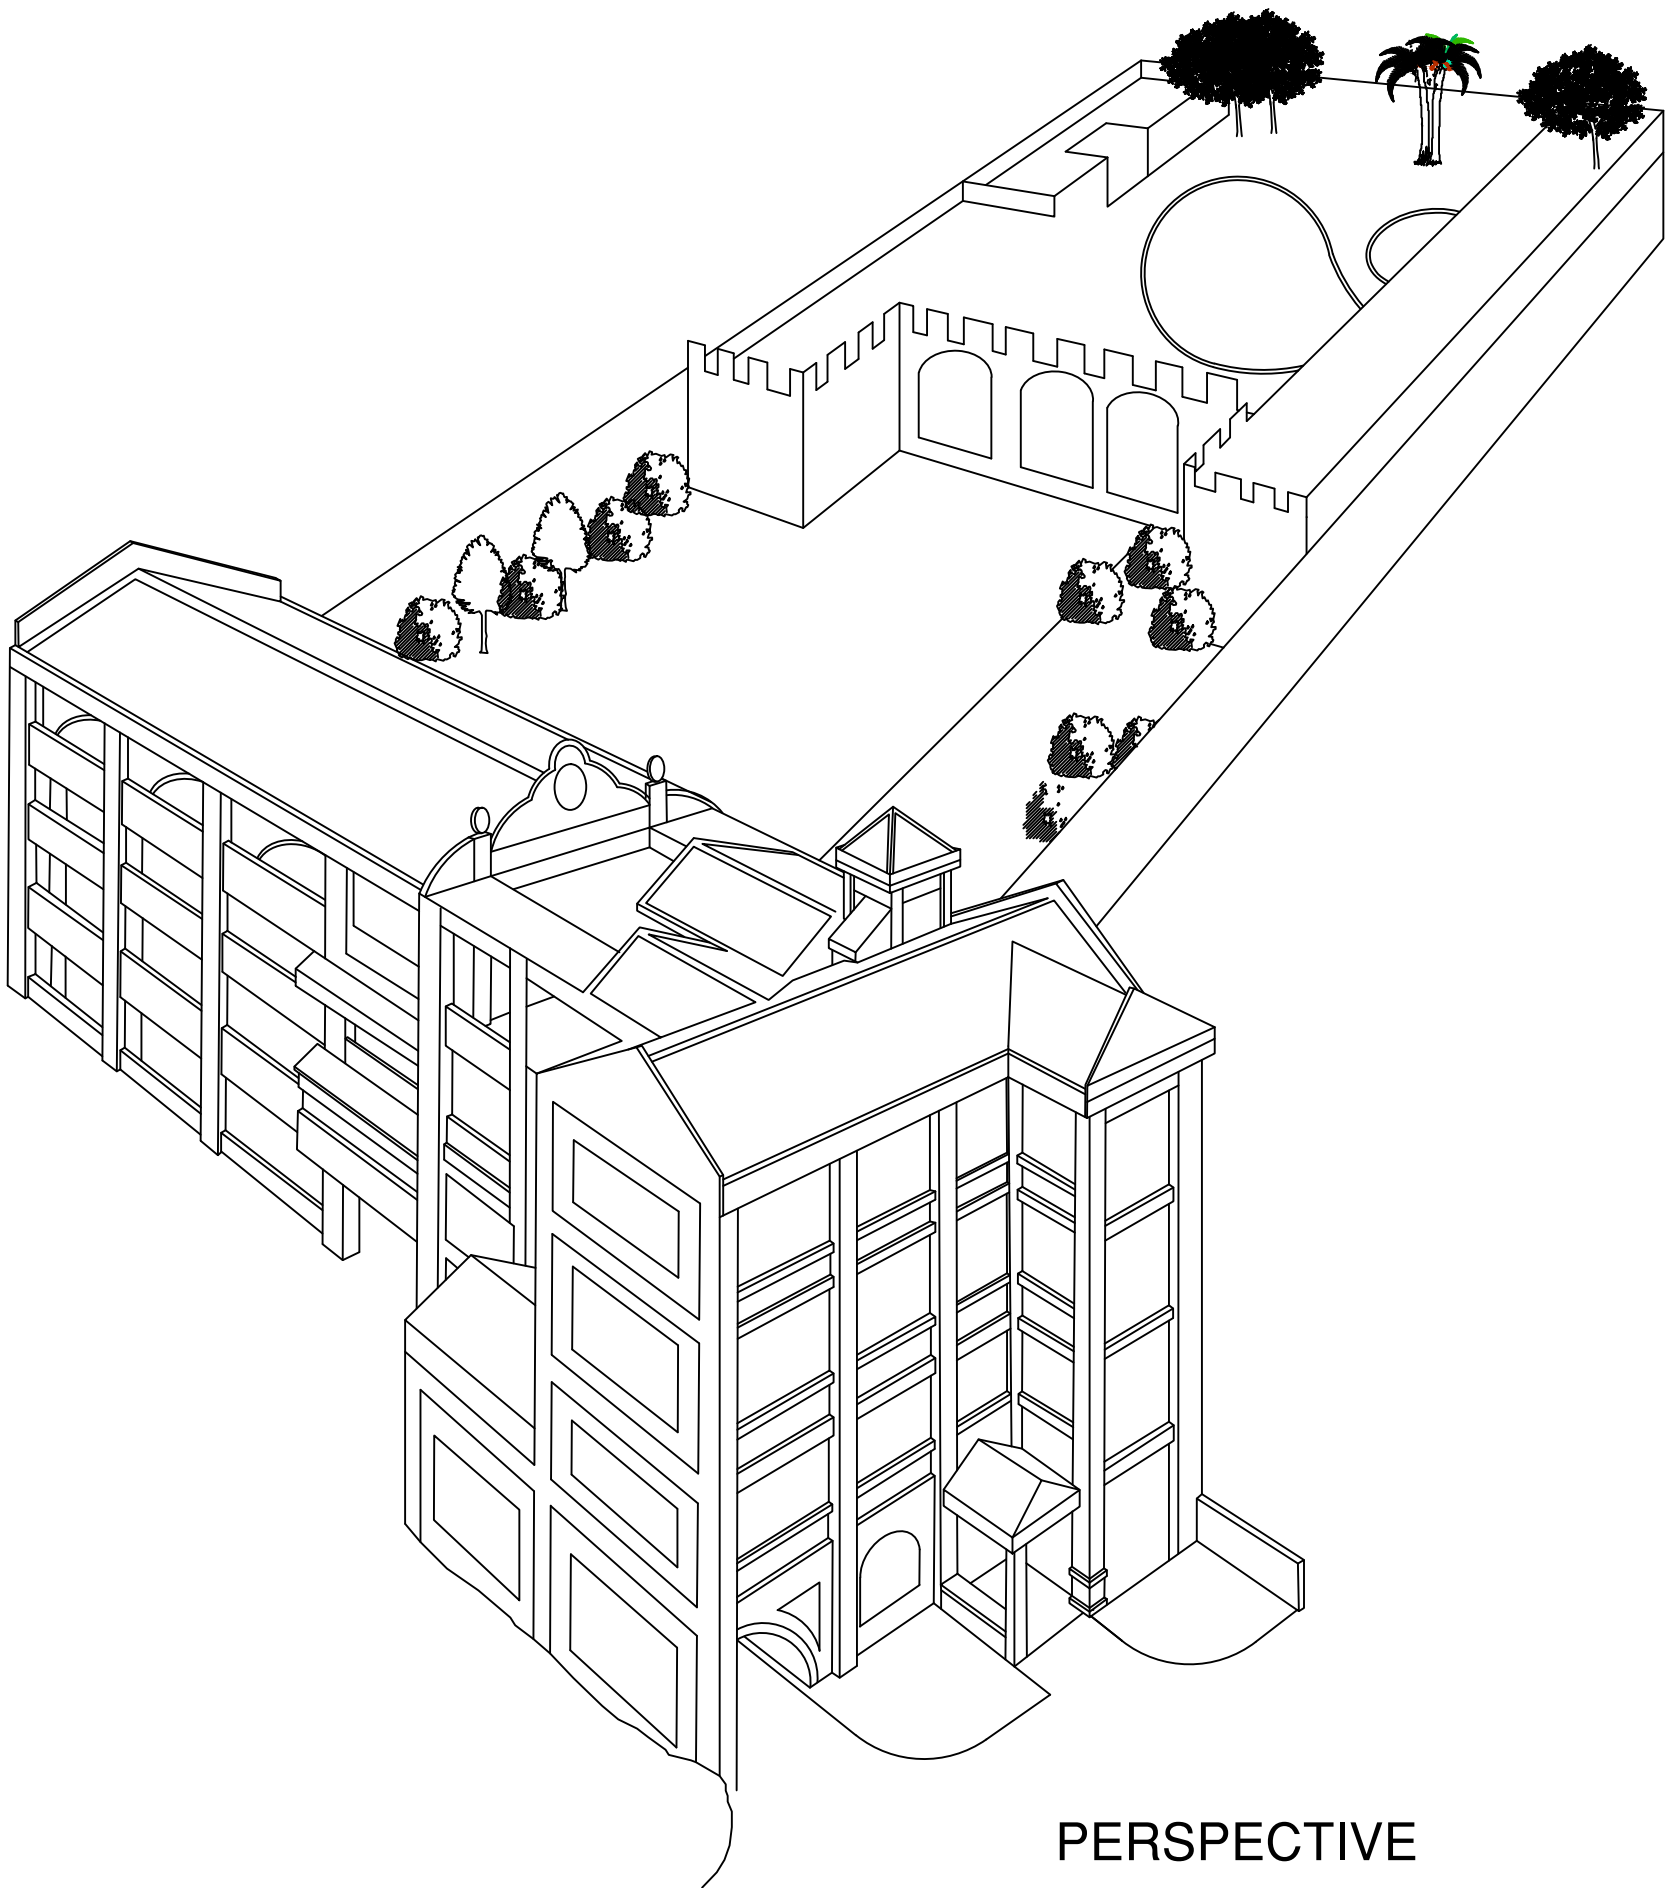


PERSPECTIVE

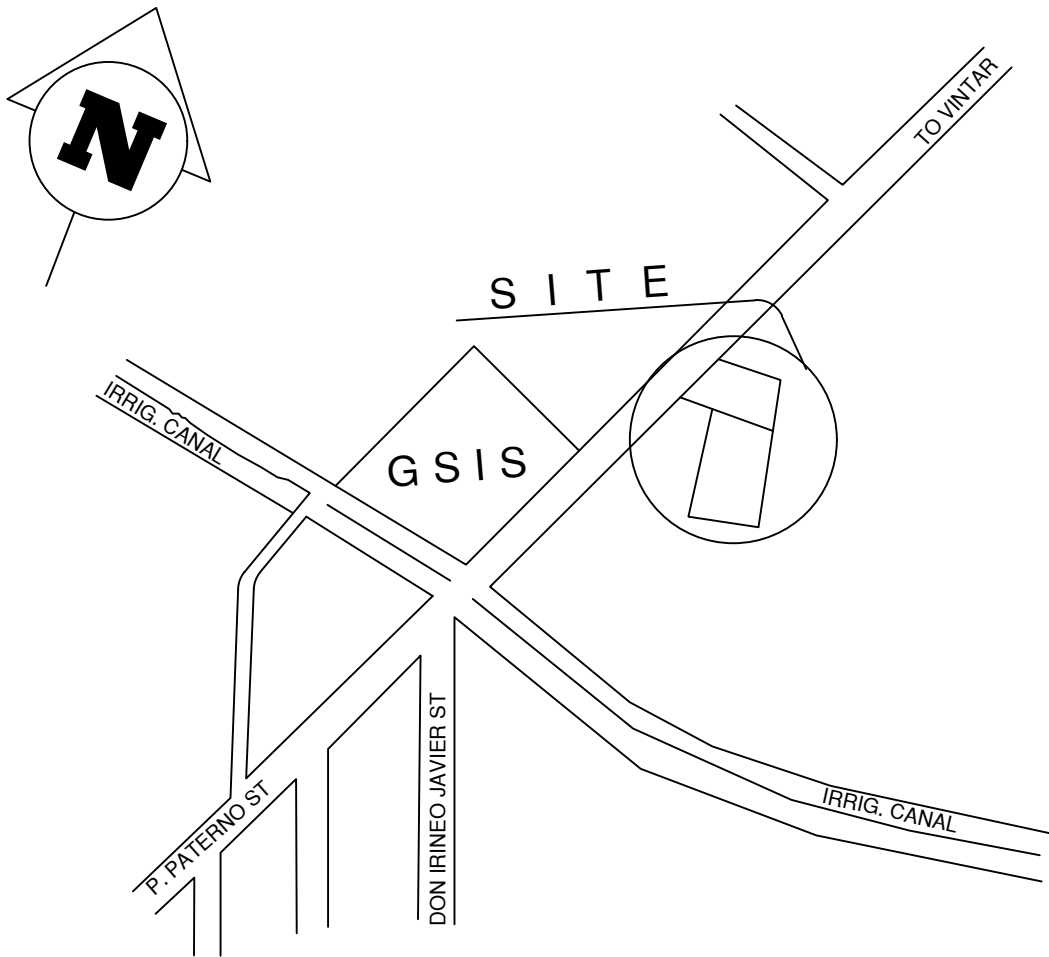

VICINITY MAP

- LEGENDS
- 1/2" BI PIPE S 40
 - 1" BI PIPE S 40
 - 1 1/4" BI PIPE S 40
 - 1 1/2" BI PIPE S 40
 - SPRINKLER
 - MOTOR 3HP


				DRAFTED BY:	CHECKED BY:	MARK	DATE	PROJECT TITLE:	COMFORME;	SHEET NO.
				IMB				AS BUILT PLAN OF PALACIO DE LAOAG		
					REVISION			FIRE AND SPRINKLER	THE PALACIO DE LAOAG INC.	
								LOCATION: BRGY. 27 P. PATERNO ST. LAOAG CITY	O W N E R	

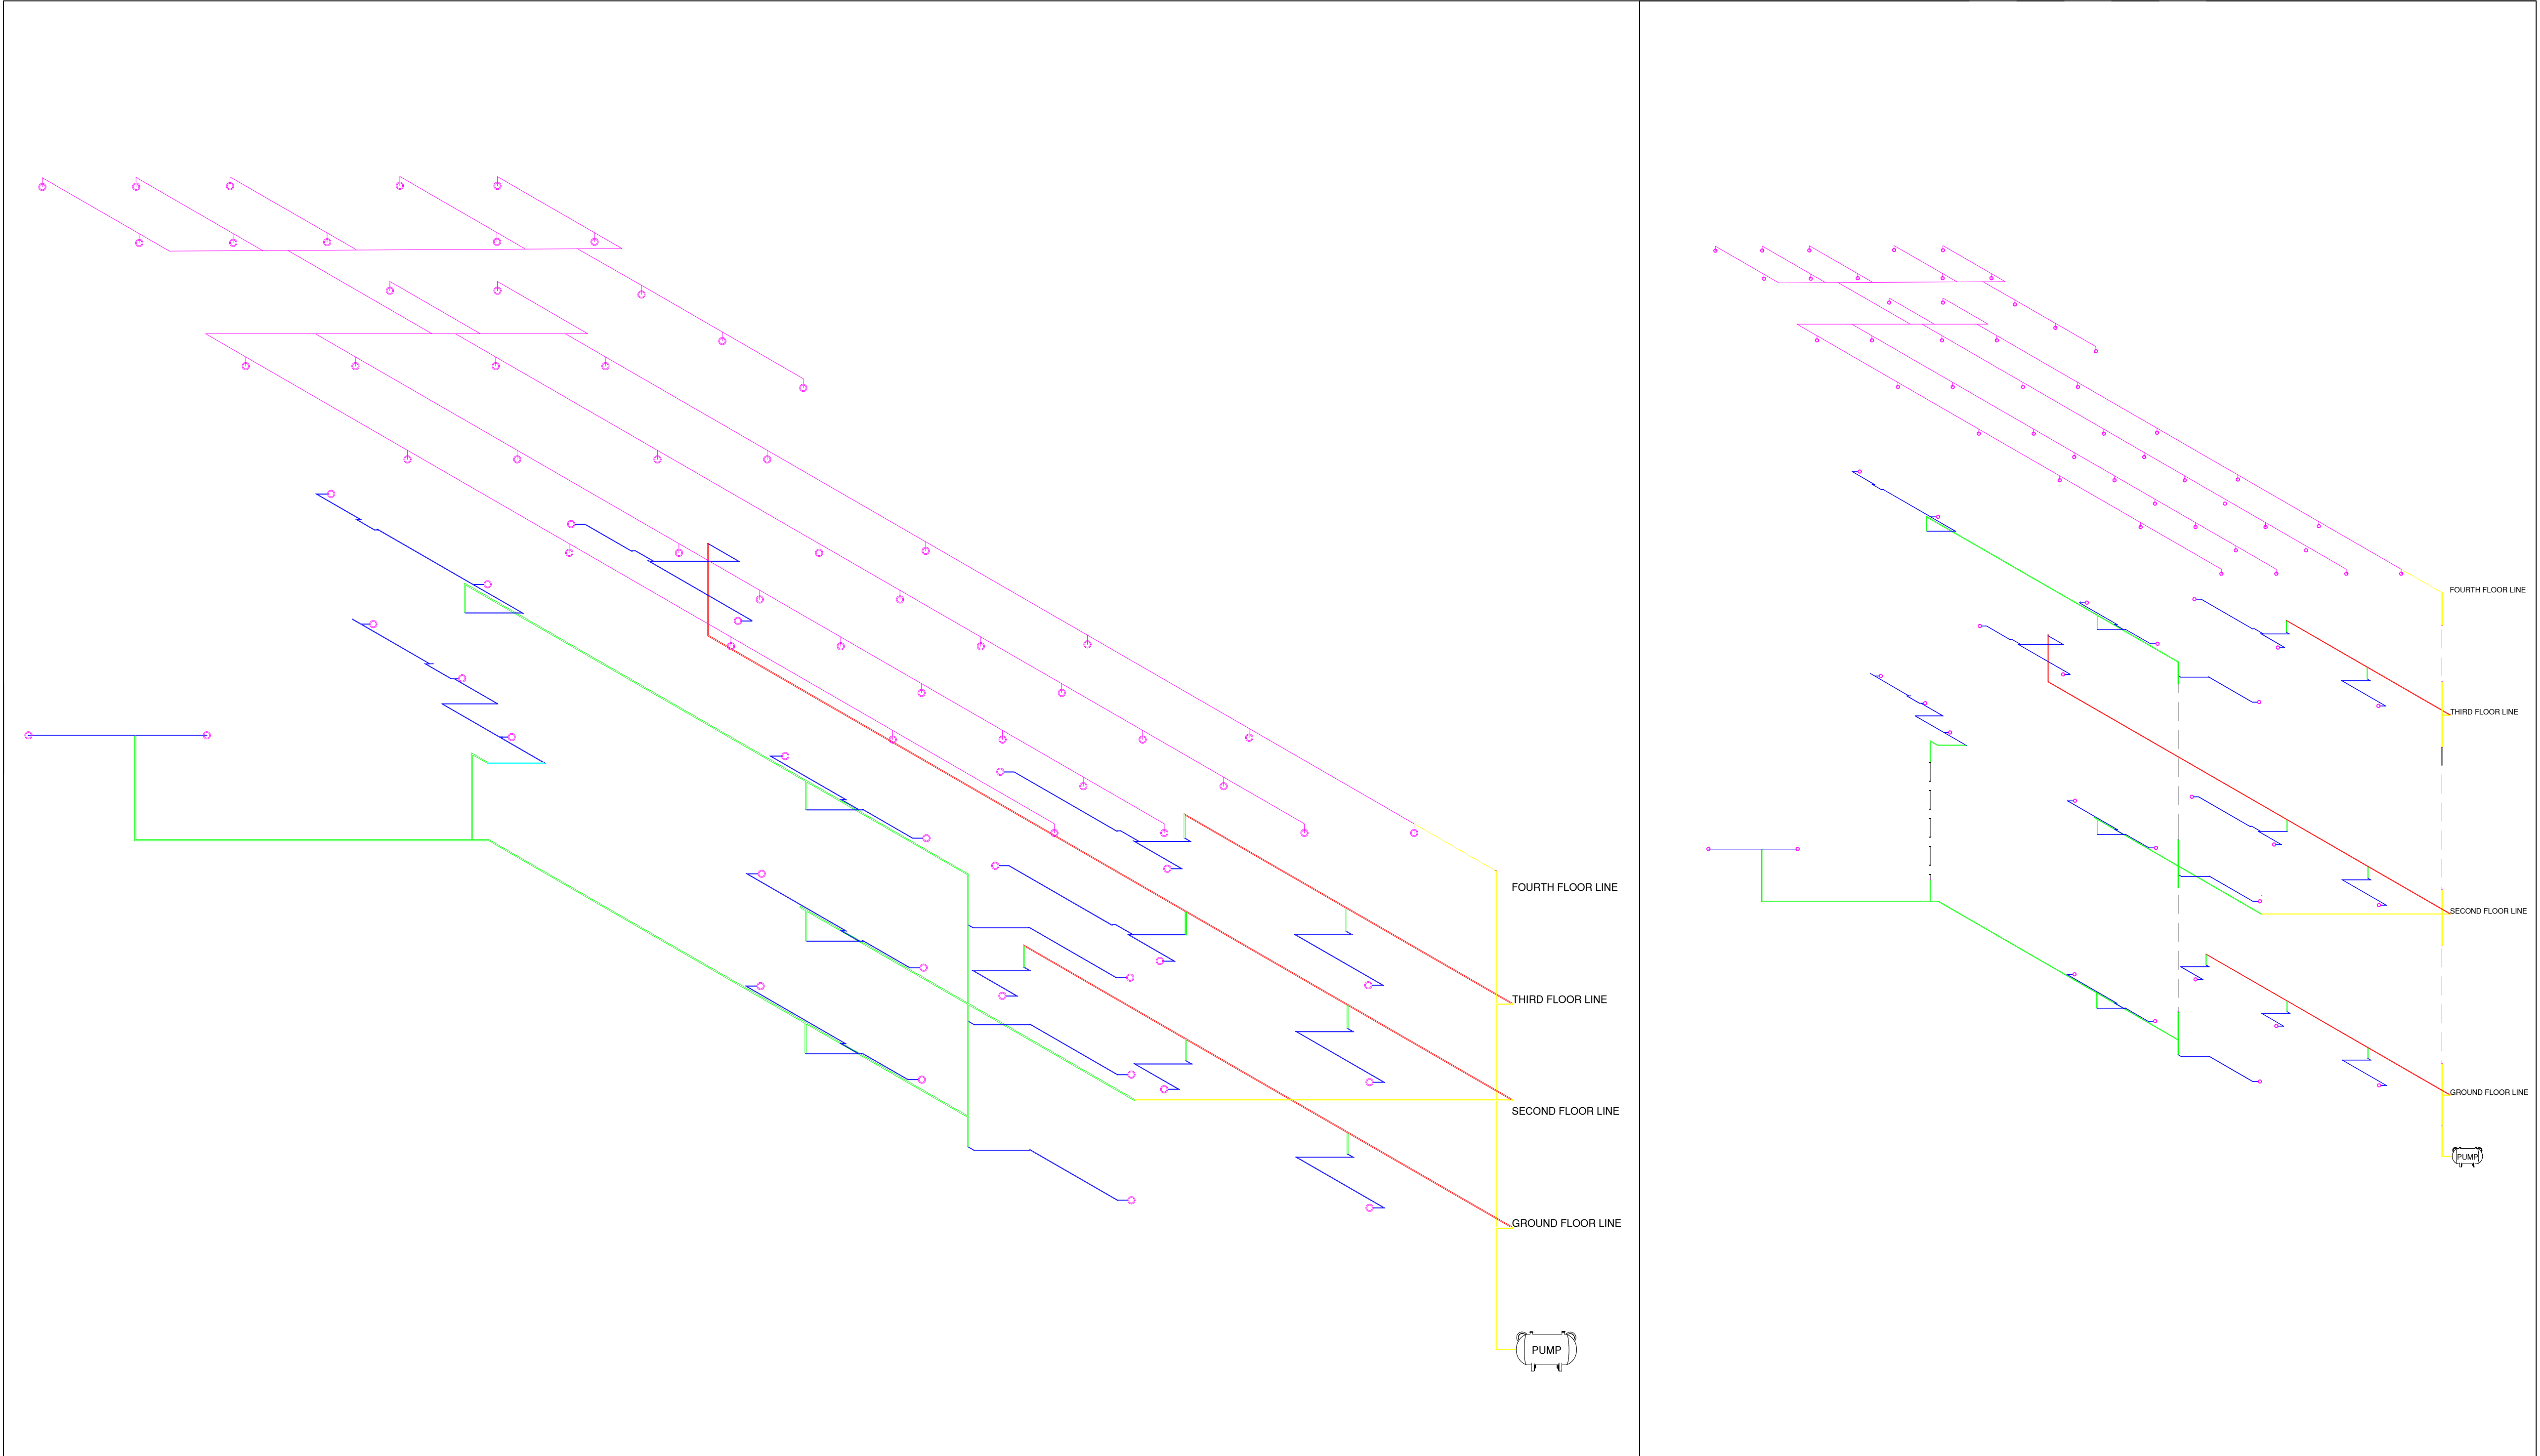

1
A-1 SINGLE LINE DIAGRAM

2
A-1 SINGLE LINE DIAGRAM
(EXPLODED AXONOMETRIC)

		DRAFTED BY:	PROJECT TITLE AS BUILT PLAN OF PALACIO DE LAOAG FIRE AND SPRINKLER LOCATION: BRGY. 27 VINTAR RD. LAOAG CITY	OWNER: THE PALACIO DE LAOAG INC.	SHEET CONTENTS: SINGLE LINE DIAGRAM	
		I M B				

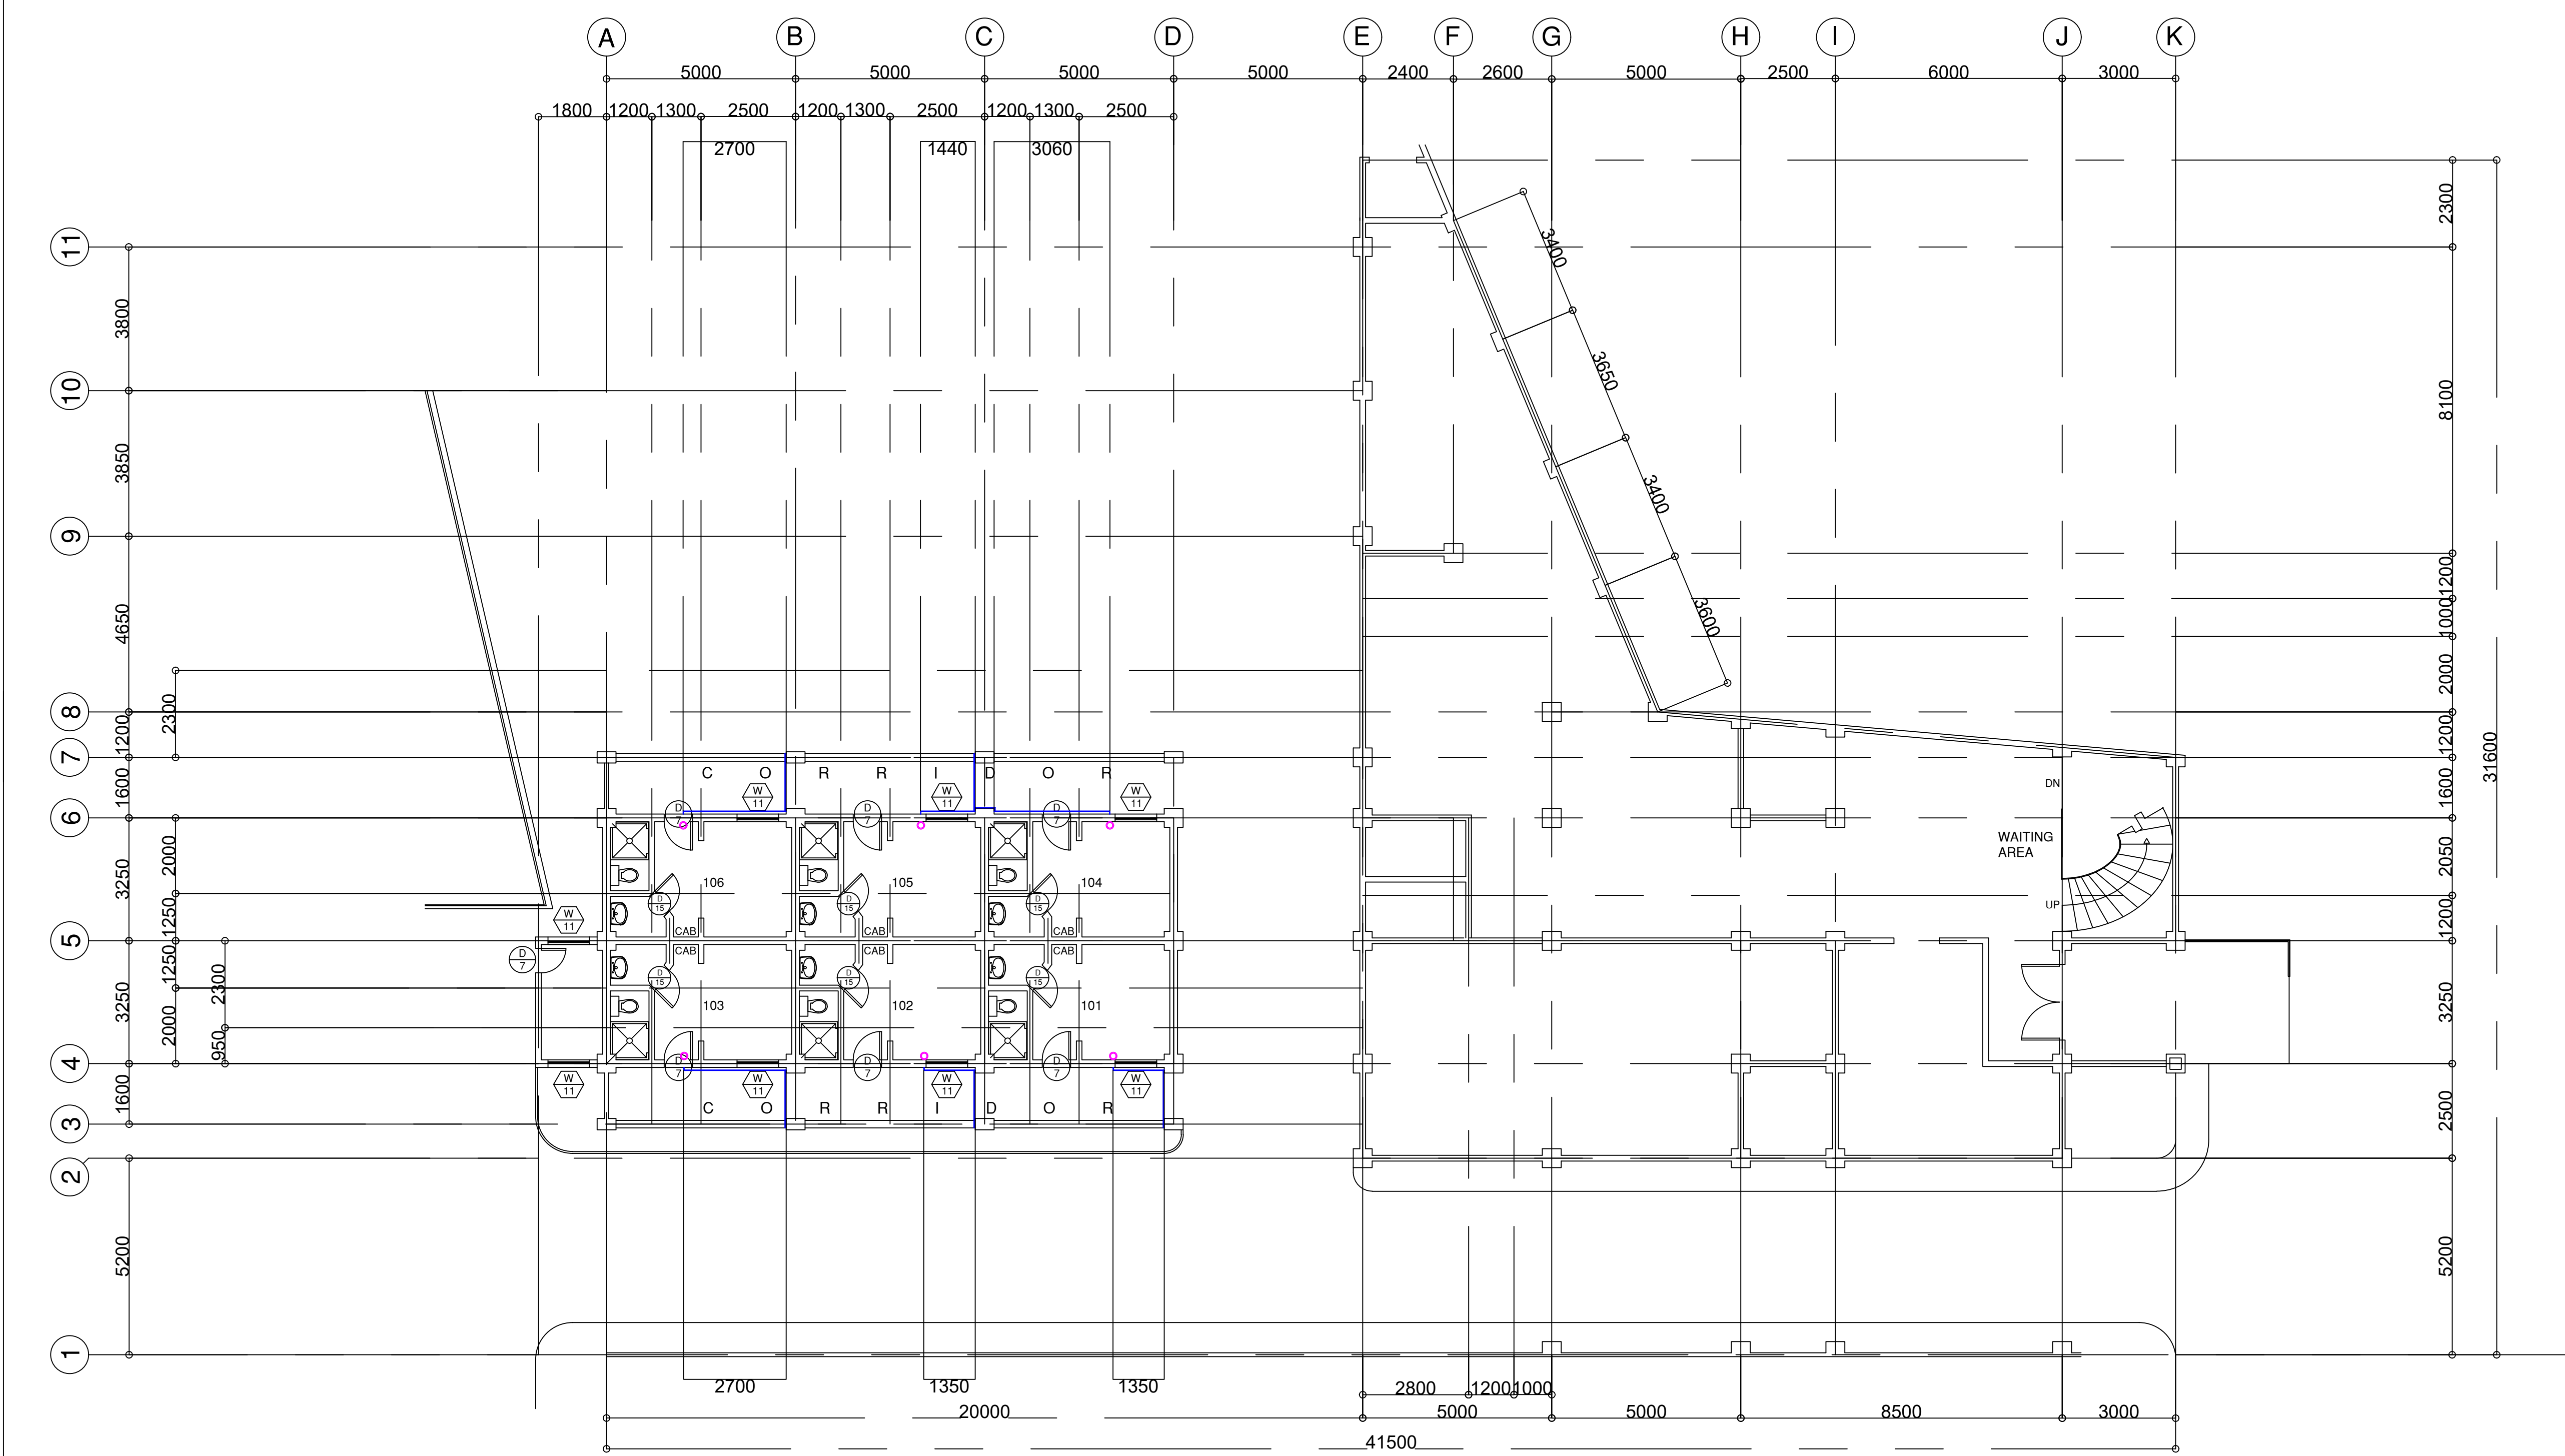


1
A-2

GROUND FLOOR PLAN

SCALE 1:100 MTS

		DRAFTED BY:	PROJECT TITLE	OWNER:	SHEET CONTENTS:	
		I M B	AS BUILT PLAN OF PALACIO DE LAOAG FIRE AND SPRINKLER	THE PALACIO DE LAOAG INC.	GROUND FLOOR PLAN	
			LOCATION: BRGY. 27 VINTAR RD. LAOAG CITY			

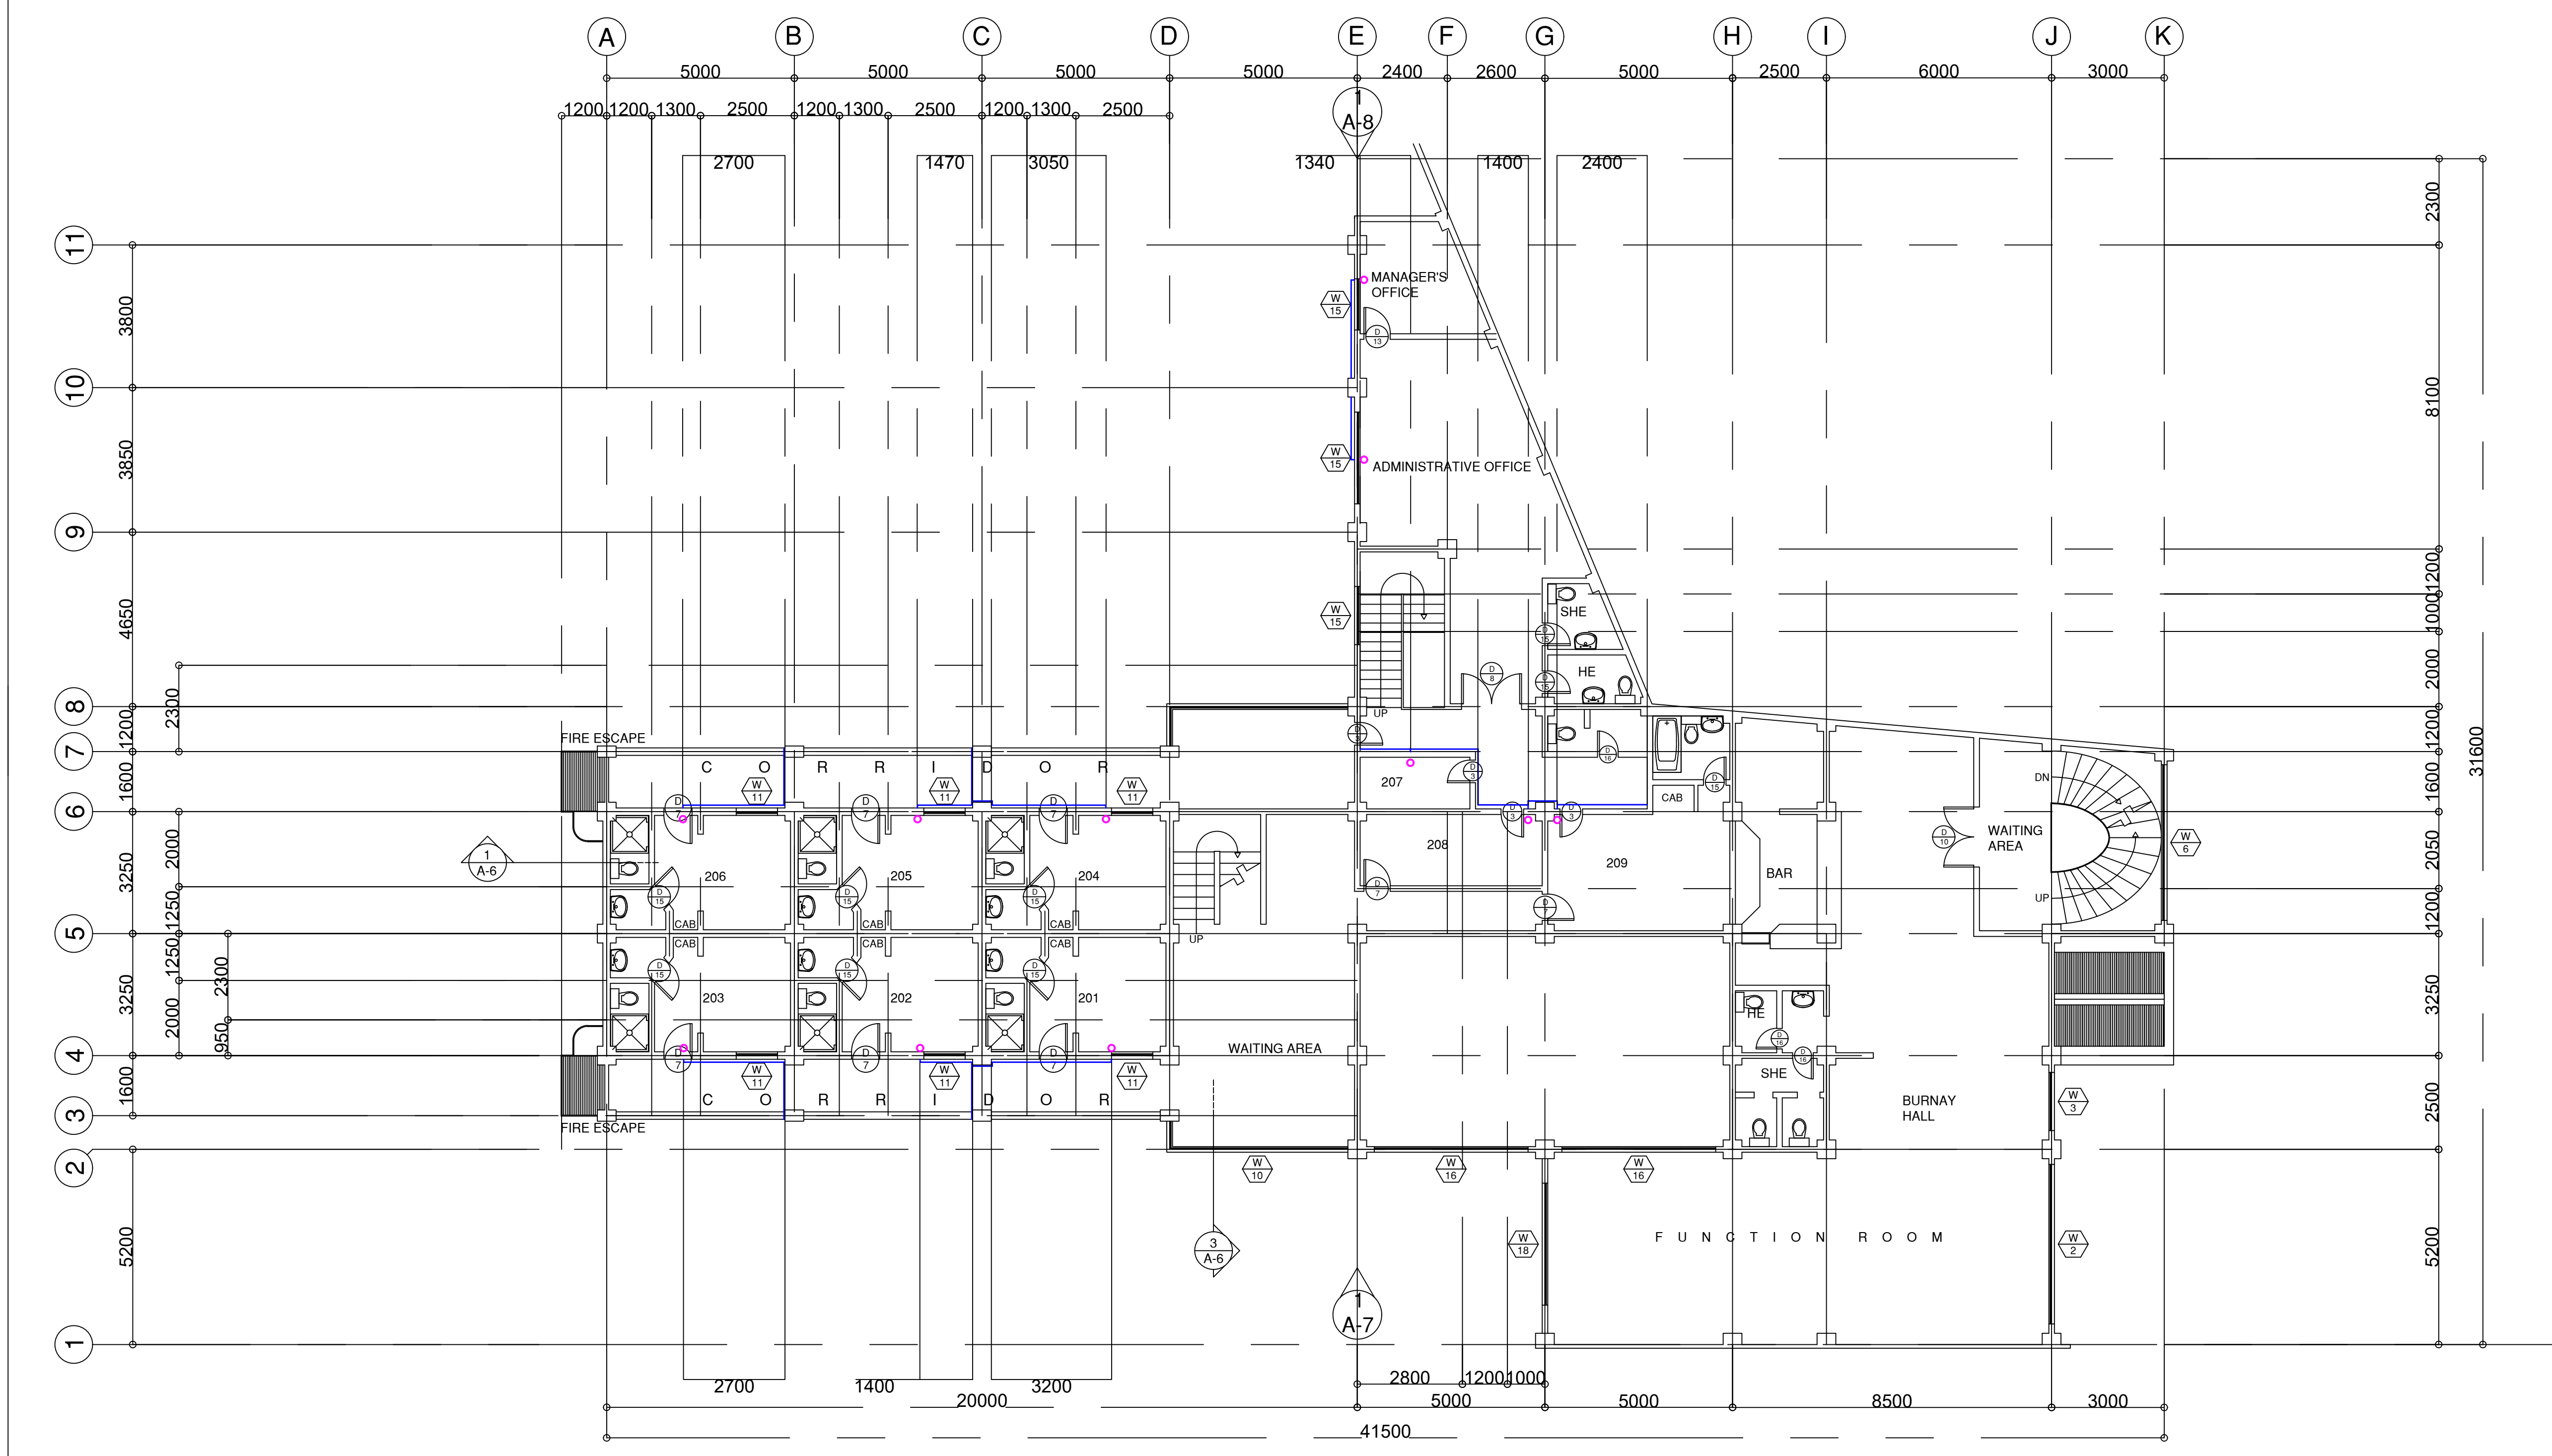


1
A-3

SECOND FLOOR PLAN


SCALE 1:100 MTS

		DRAFTED BY:	PROJECT TITLE	OWNER:	SHEET CONTENTS:
		I M B	AS BUILT PLAN OF PALACIO DE LAOAG FIRE AND SPRINKLER	THE PALACIO DE LAOAG INC.	SECOND FLOOR PLAN
			LOCATION: BRGY. 27 VINTAR RD. LAOAG CITY		

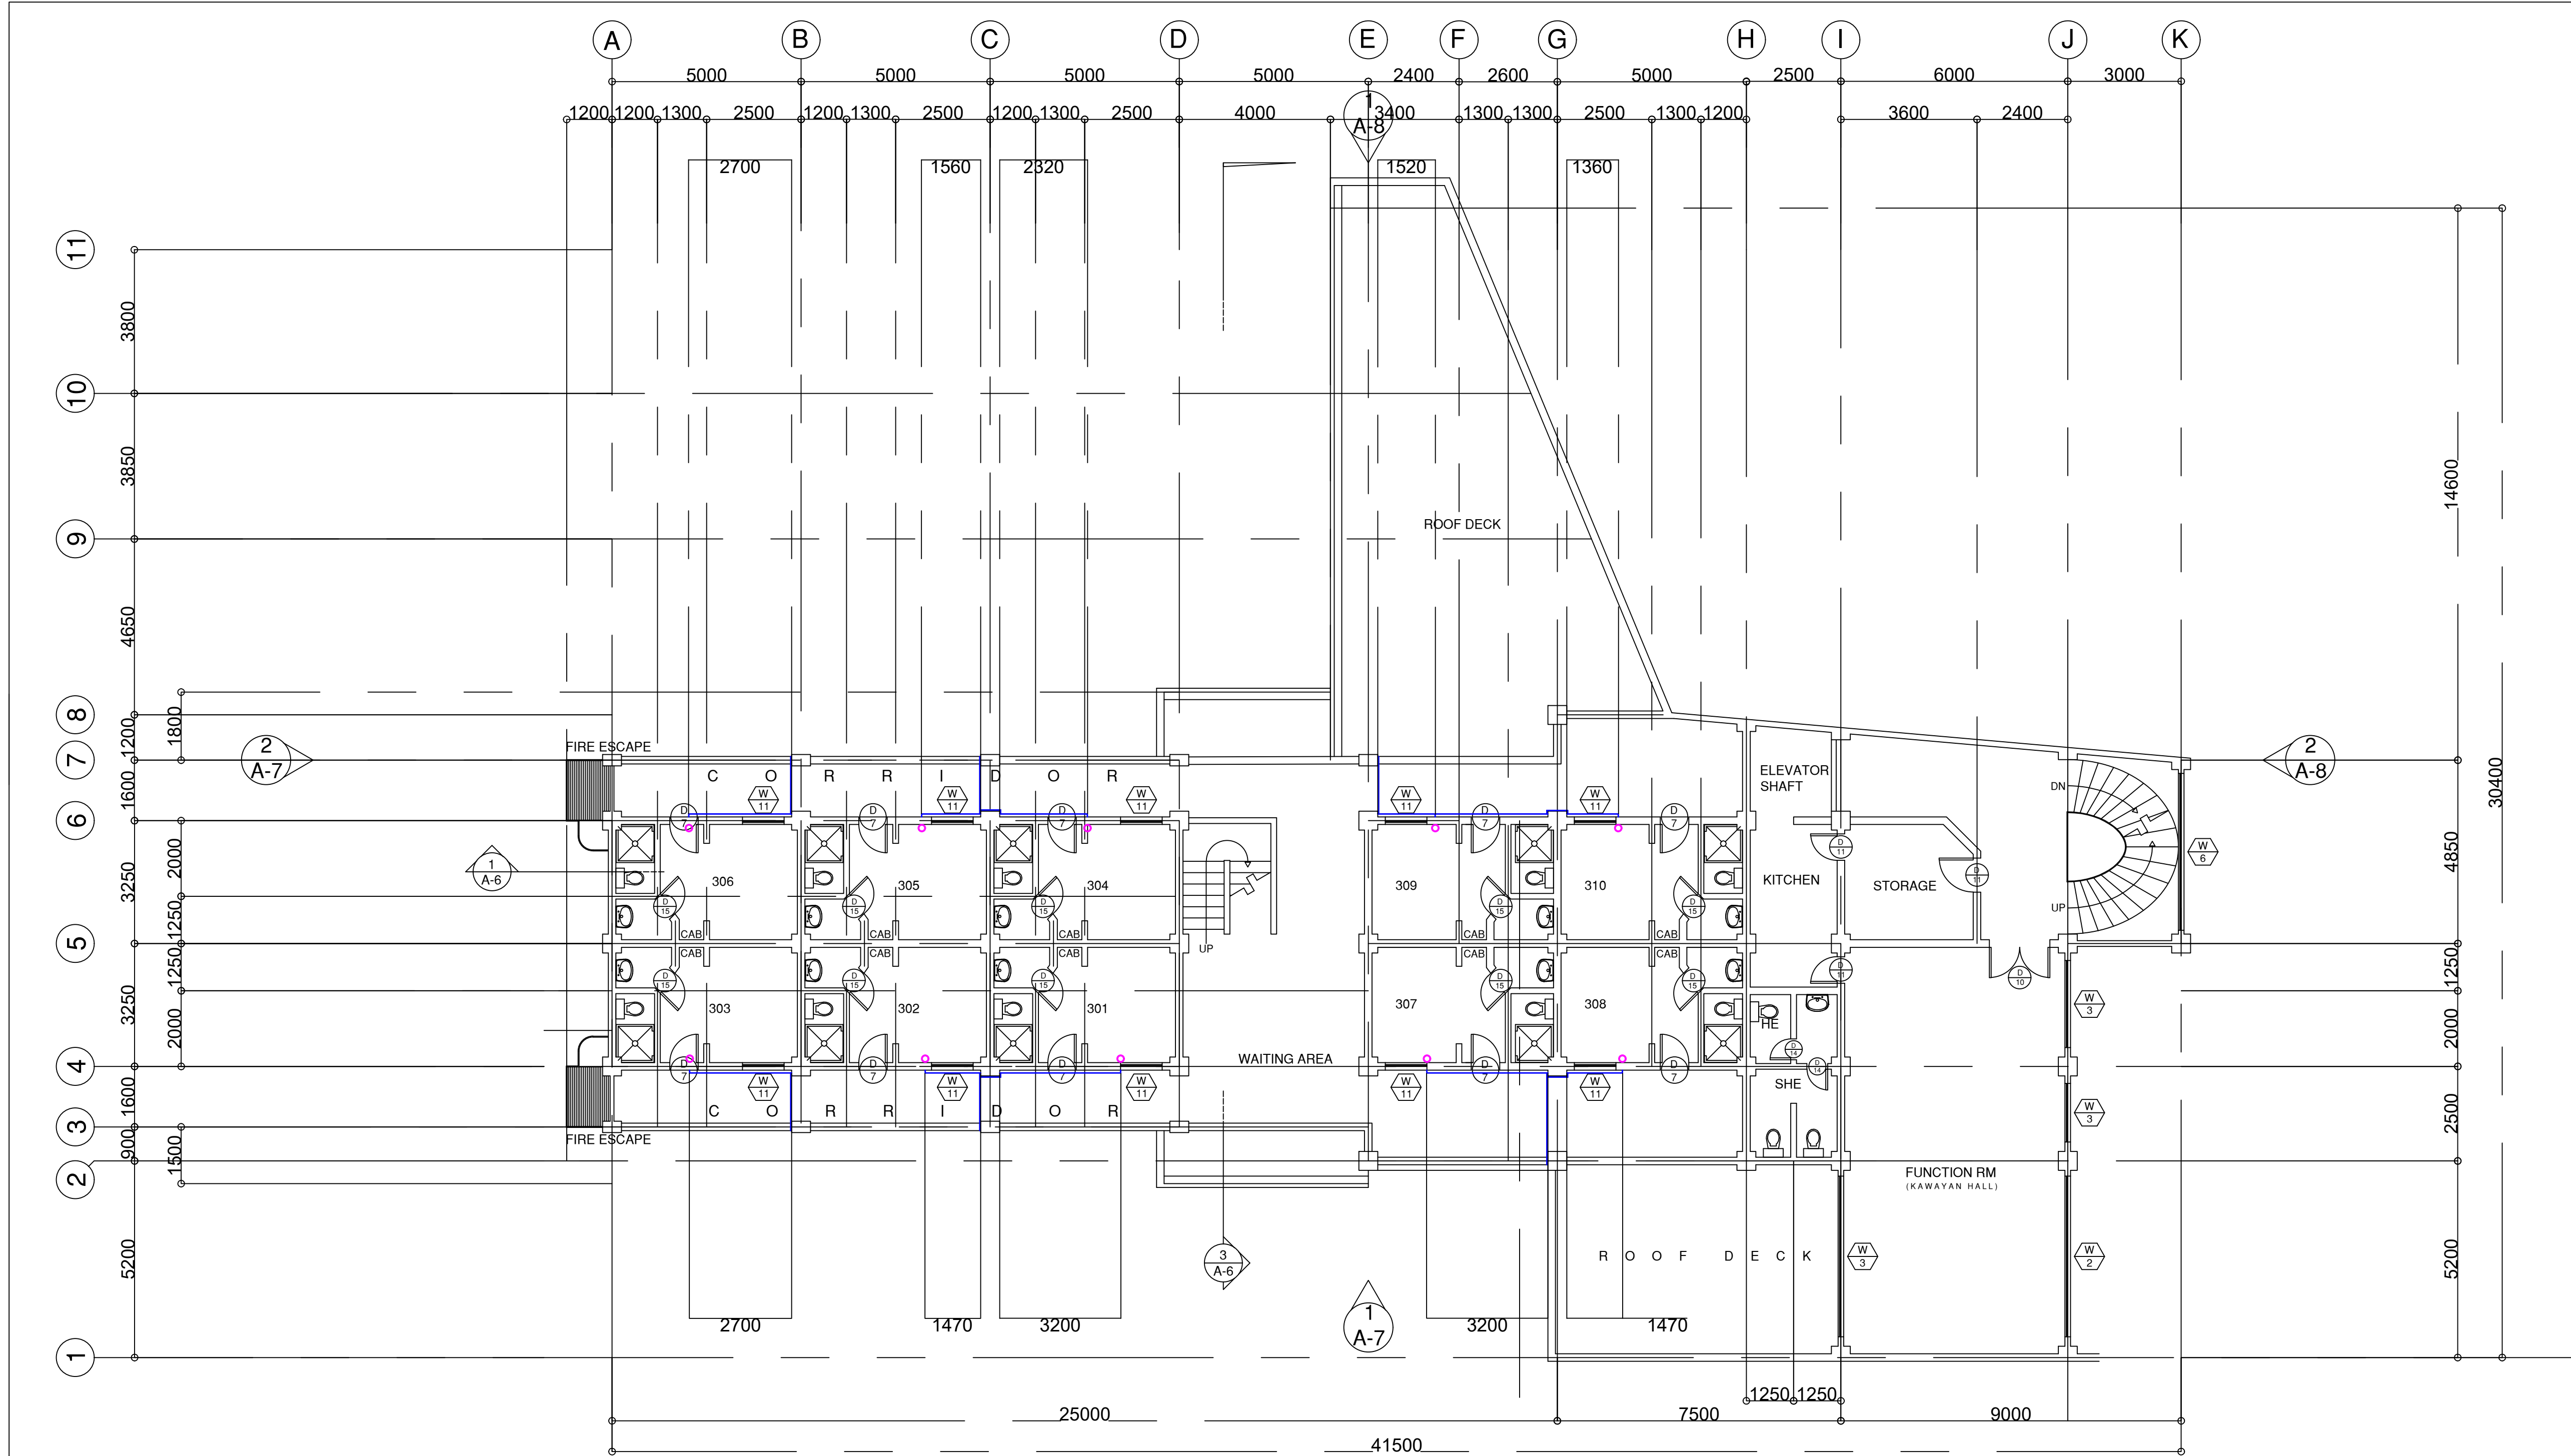

1
A-4 **THIRD FLOOR PLAN**
SCALE 1:100 MTS


		DRAFTED BY:	PROJECT TITLE	OWNER:	SHEET CONTENTS:
		I M B	AS BUILT PLAN OF PALACIO DE LAOAG FIRE AND SPRINKLER	THE PALACIO DE LAOAG INC.	THIRD FLOOR PLAN
			LOCATION: BRGY. 27 VINTAR RD. LAOAG CITY		

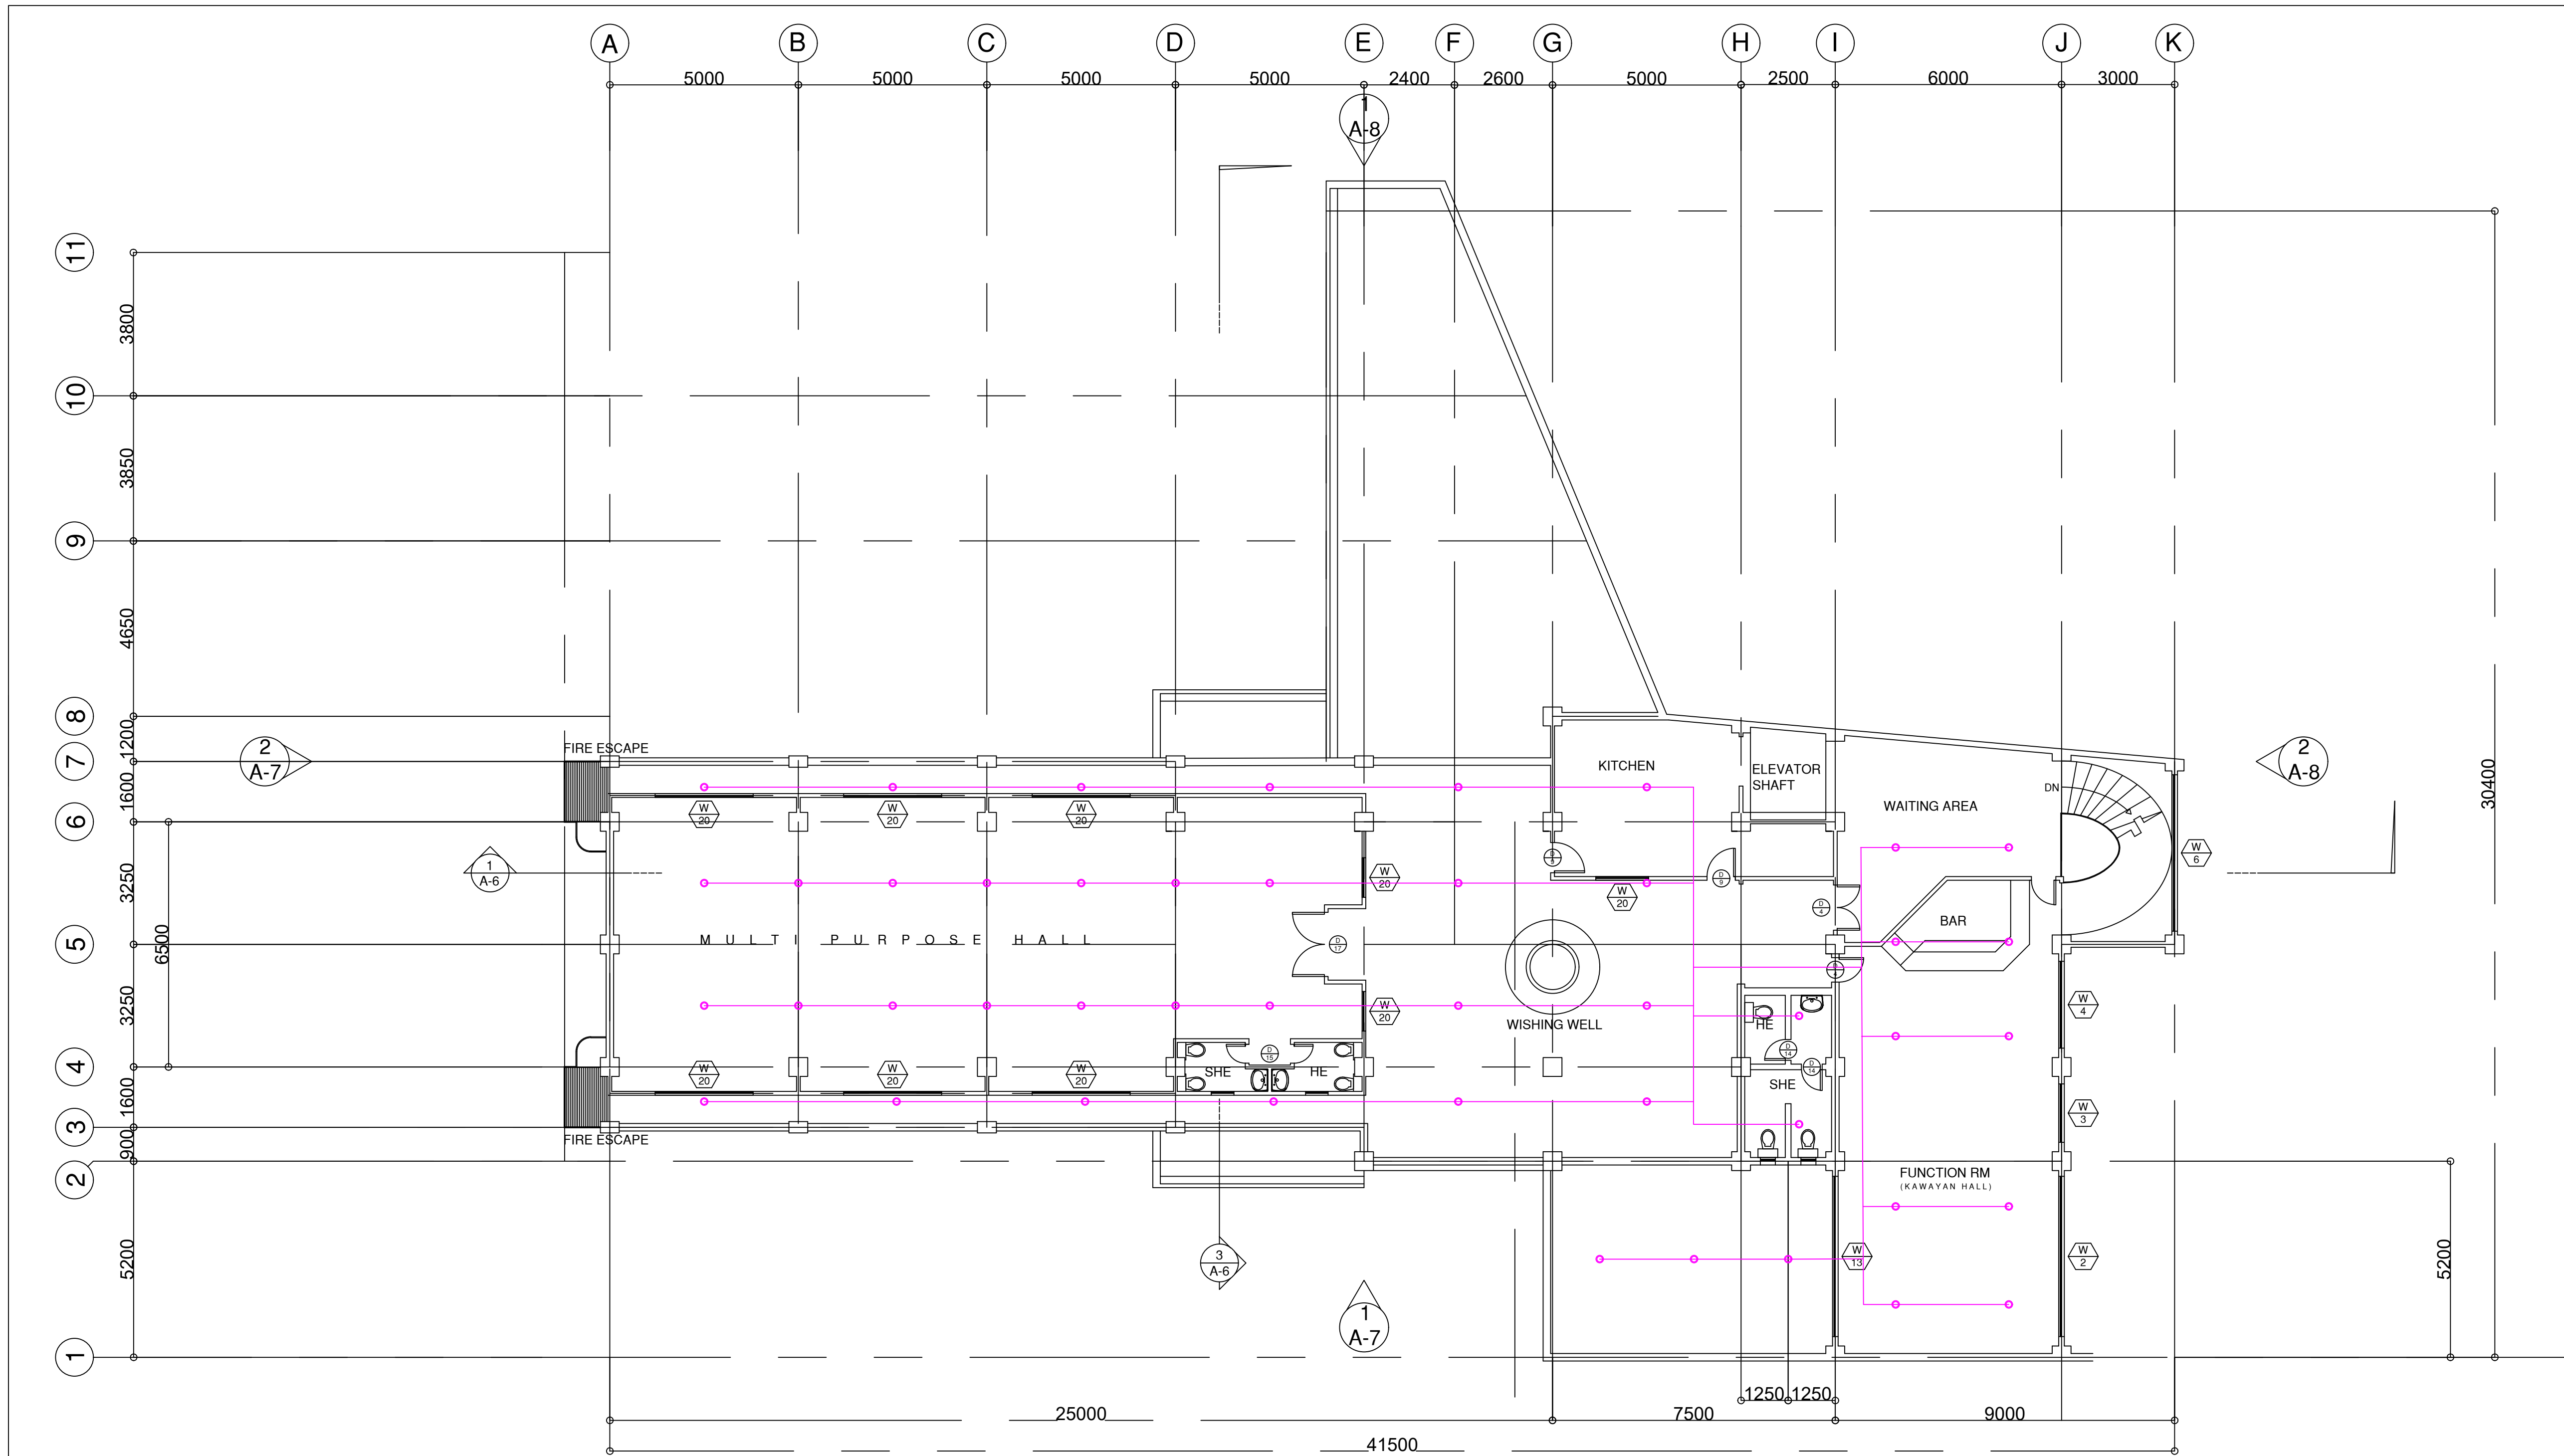


1
A-5
SCALE
1:100 MTS

FOURTH FLOOR PLAN

		DRAFTED BY:	PROJECT TITLE	OWNER:	SHEET CONTENTS:	
		I M B	AS BUILT PLAN OF PALACIO DE LAOAG FIRE AND SPRINKLER	THE PALACIO DE LAOAG INC.	FOURTH FLOOR PLAN	
			LOCATION: BRGY. 27 VINTAR RD. LAOAG CITY			

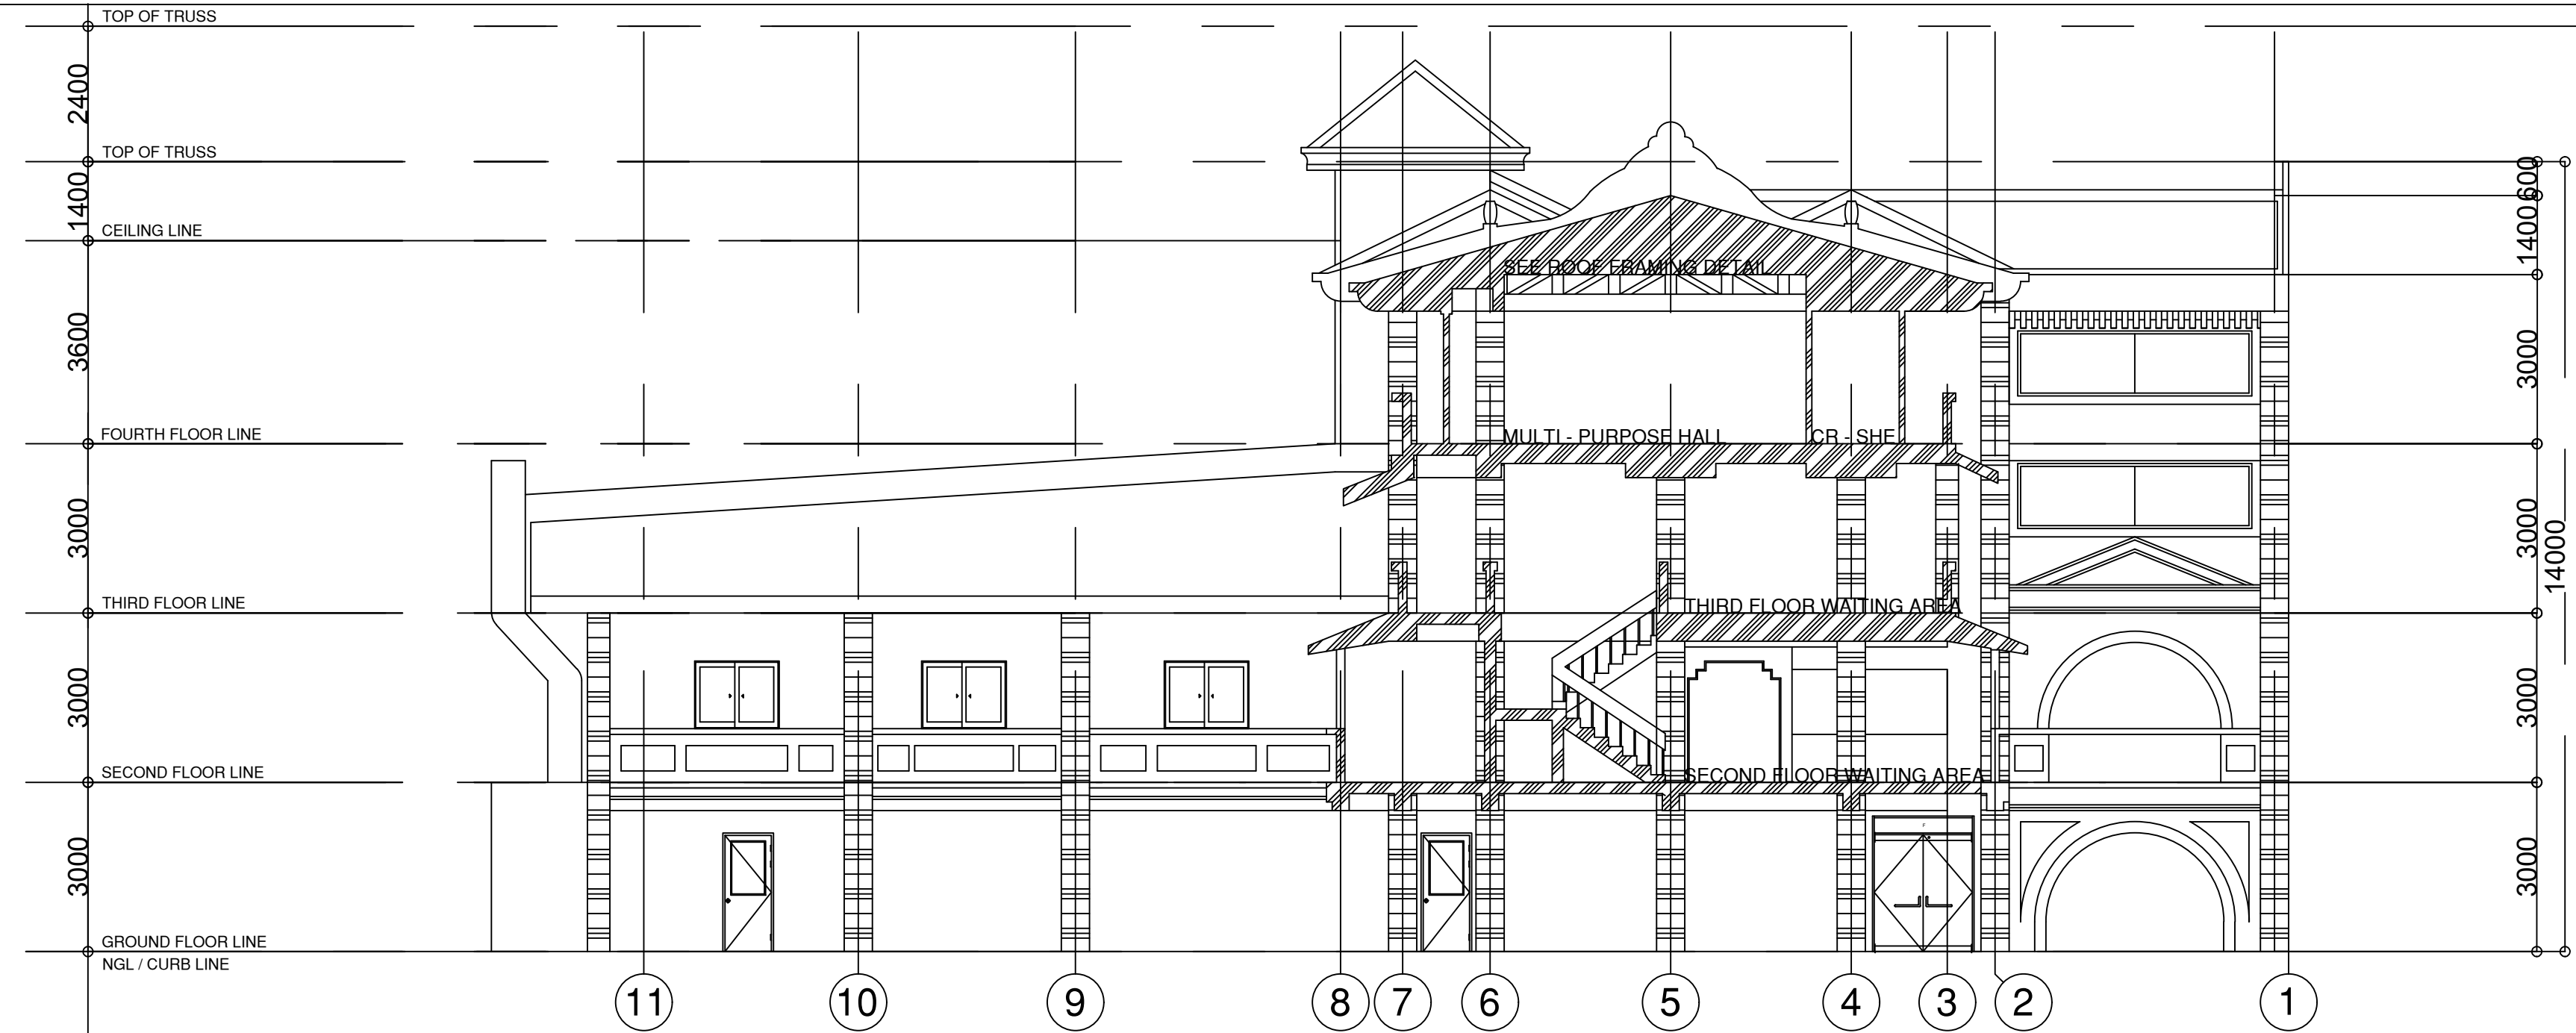

1
A-6 TRANSVERSE SECTION
SCALE 1:100 MTS

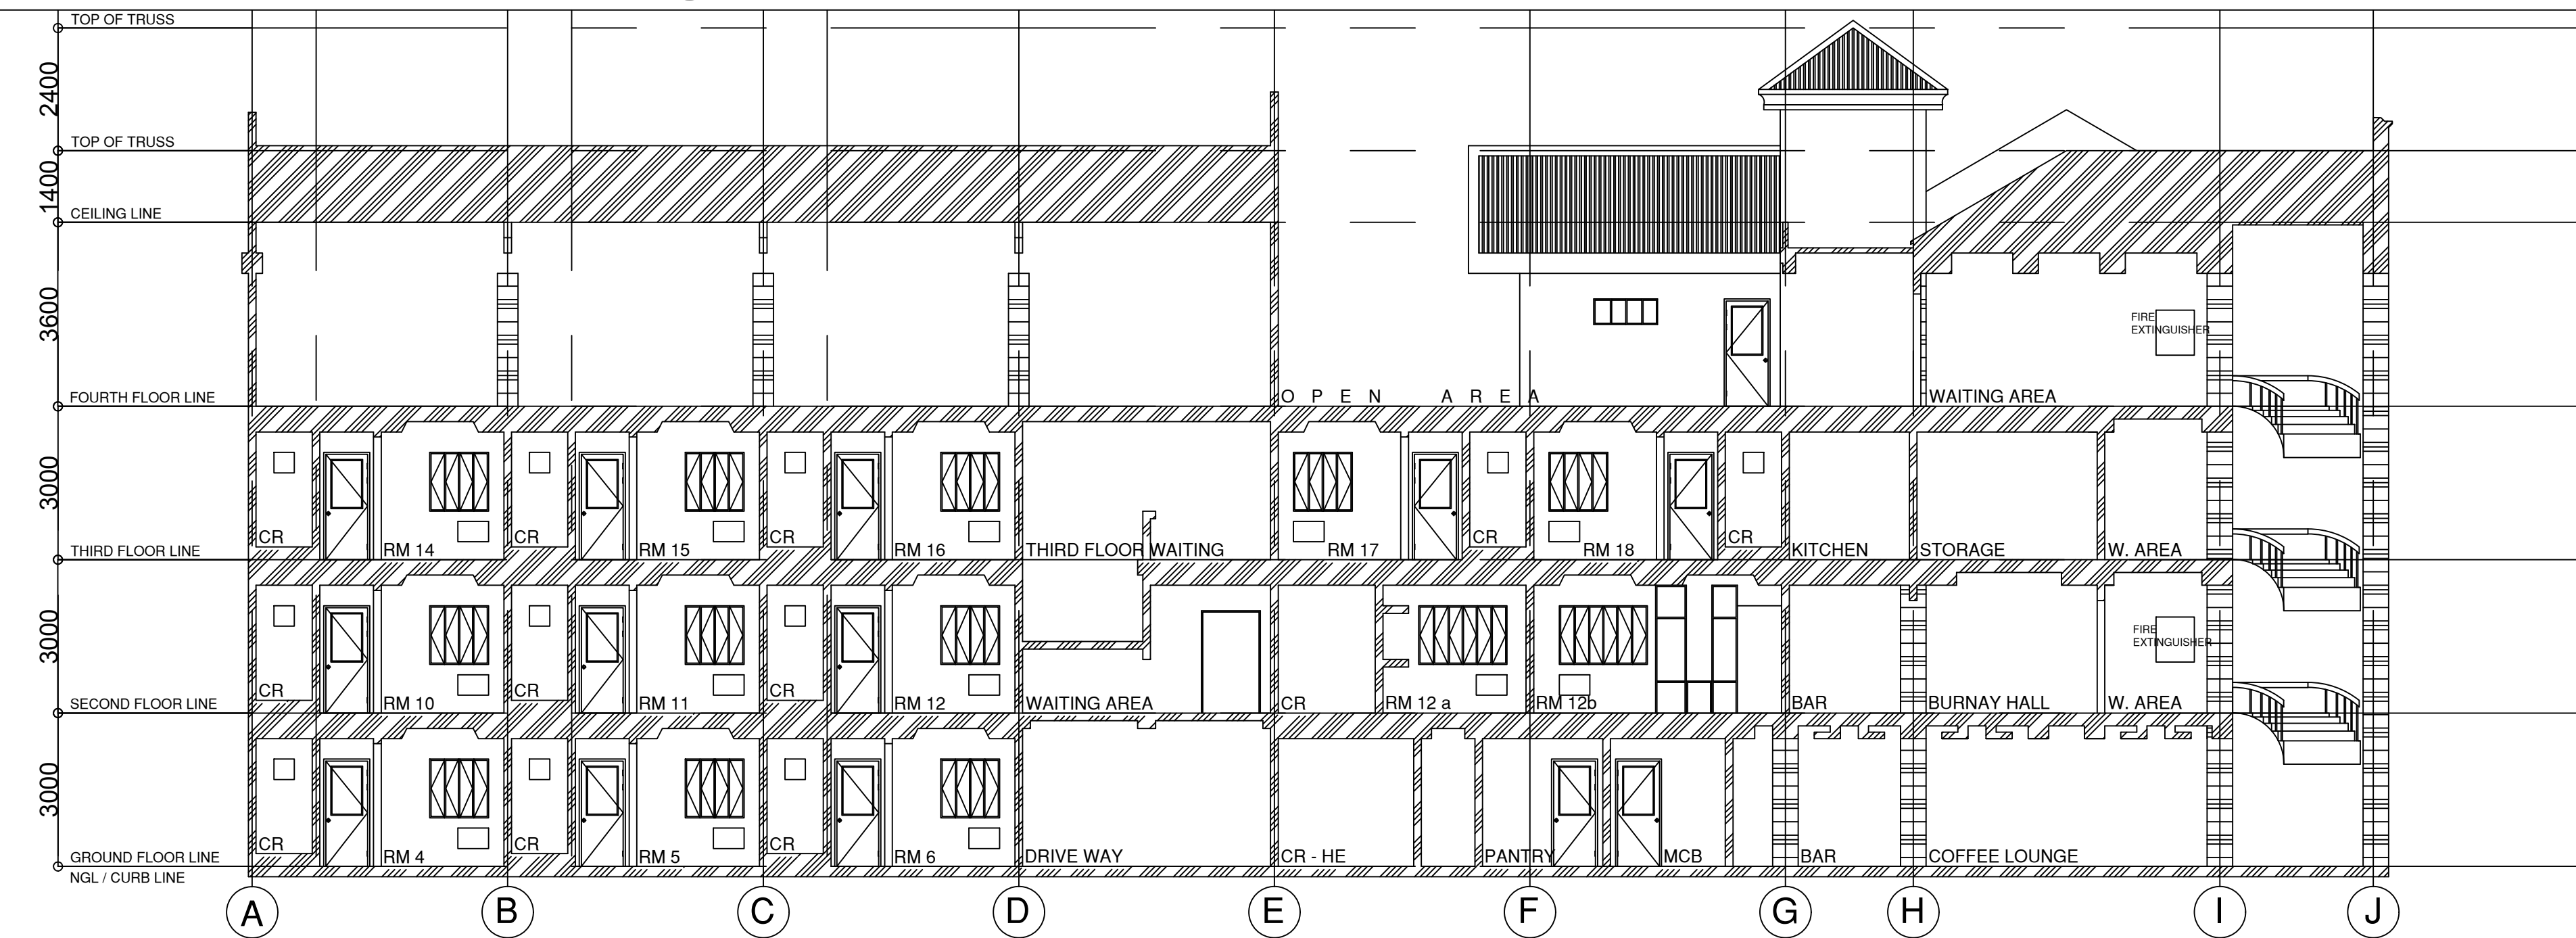


3
A-6 LONGITUDINAL SECTION
SCALE 1:100 MTS

			DRAFTED BY: I M B	PROJECT TITLE AS BUILT PLAN OF PALACIO DE LAOAG FIRE AND SPRINKLER	OWNER: THE PALACIO DE LAOAG INC.	SHEET CONTENTS: TRANSVERSE SECTION LONGITUDINAL SECTION	
				LOCATION: BRGY. 27 VINTAR RD. LAOAG CITY			



1 FRONT ELEVATION
SCALE 1:100 MTS

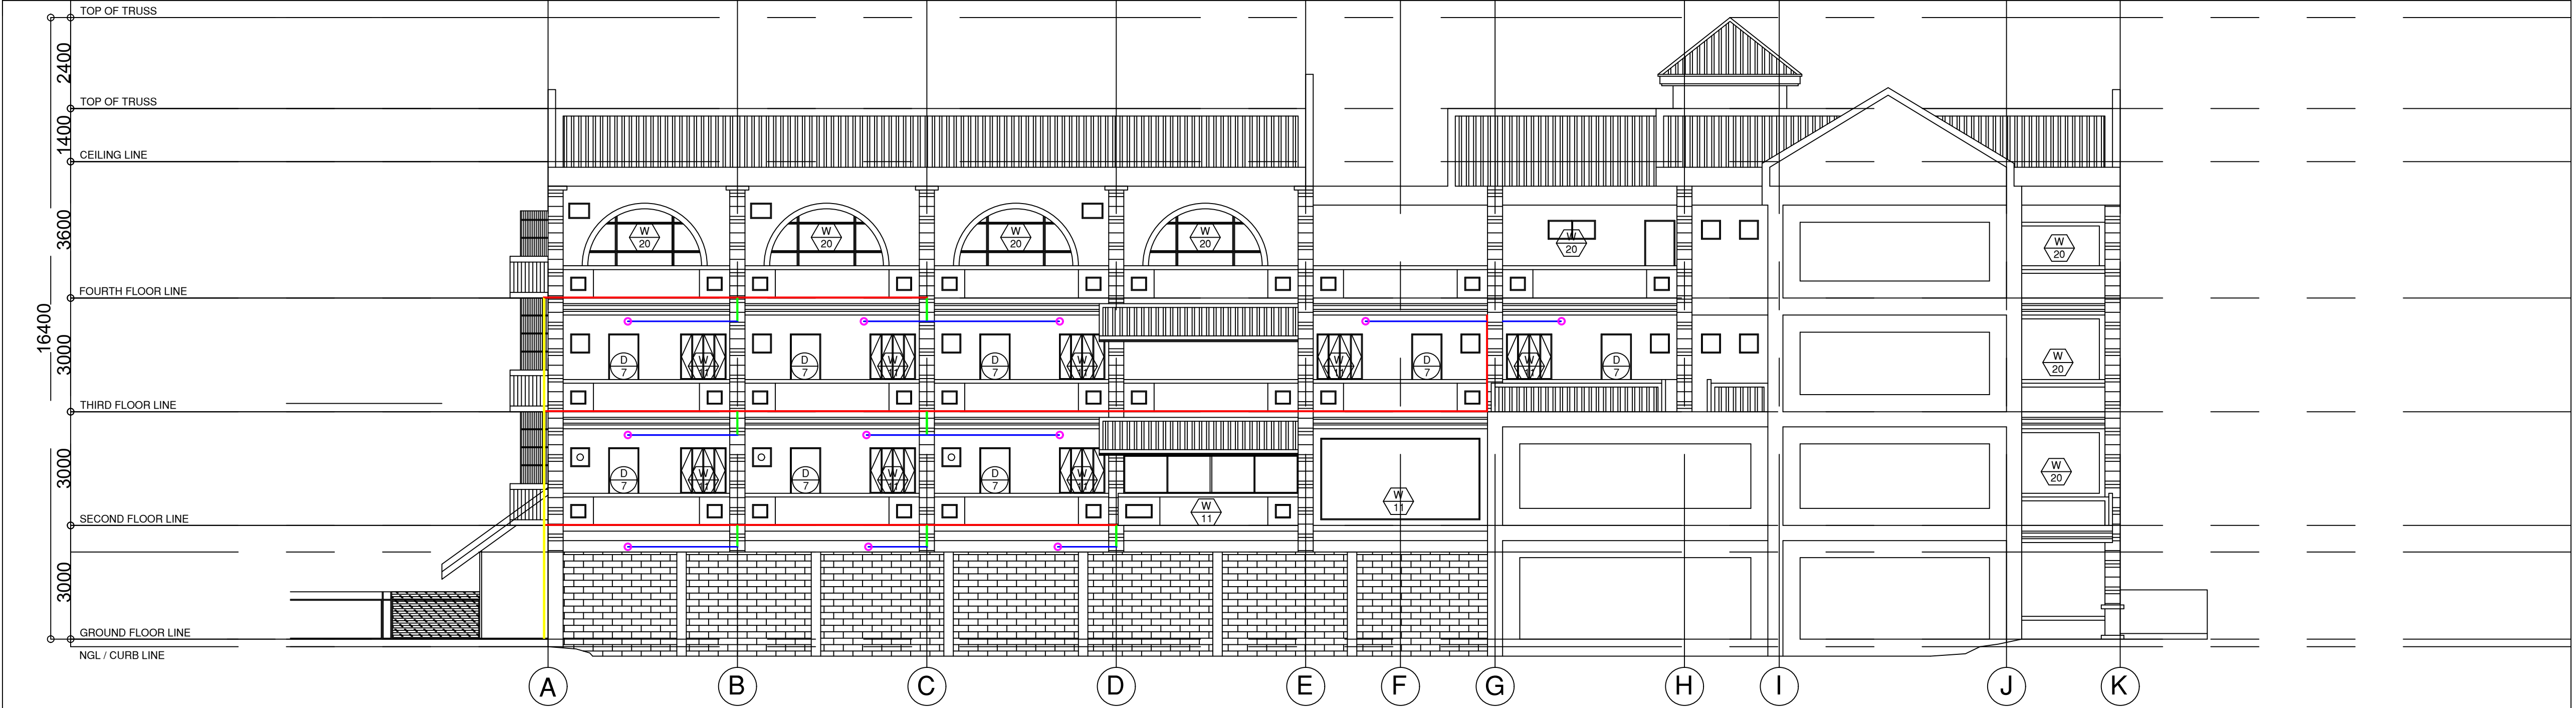

2 LEFT SIDE ELEVATION
SCALE 1:100 MTS

		DRAFTED BY:	PROJECT TITLE	OWNER:	SHEET CONTENTS:	
		I M B	AS BUILT PLAN OF PALACIO DE LAOAG FIRE AND SPRINKLER	THE PALACIO DE LAOAG INC.	FRONT ELEVATION LEFT SIDE ELEVATION	
			LOCATION: BRGY. 27 VINTAR RD. LAOAG CITY			



1
A-8 REAR ELEVATION
SCALE 1:100 MTS



2
A-8 RIGHT SIDE ELEVATION
SCALE 1:100 MTS

		DRAFTED BY:	PROJECT TITLE	OWNER:	SHEET CONTENTS:
		I M B	AS BUILT PLAN OF PALACIO DE LAOAG FIRE AND SPRINKLER	THE PALACIO DE LAOAG INC.	REAR ELEVATION RIGHT SIDE ELEVATION
			LOCATION: BRGY. 27 VINTAR RD. LAOAG CITY		